


09/11/02 WED 15:03 FAX 21925299

IncomingFax/Data

280 609-0169-0002

MARKED-UP

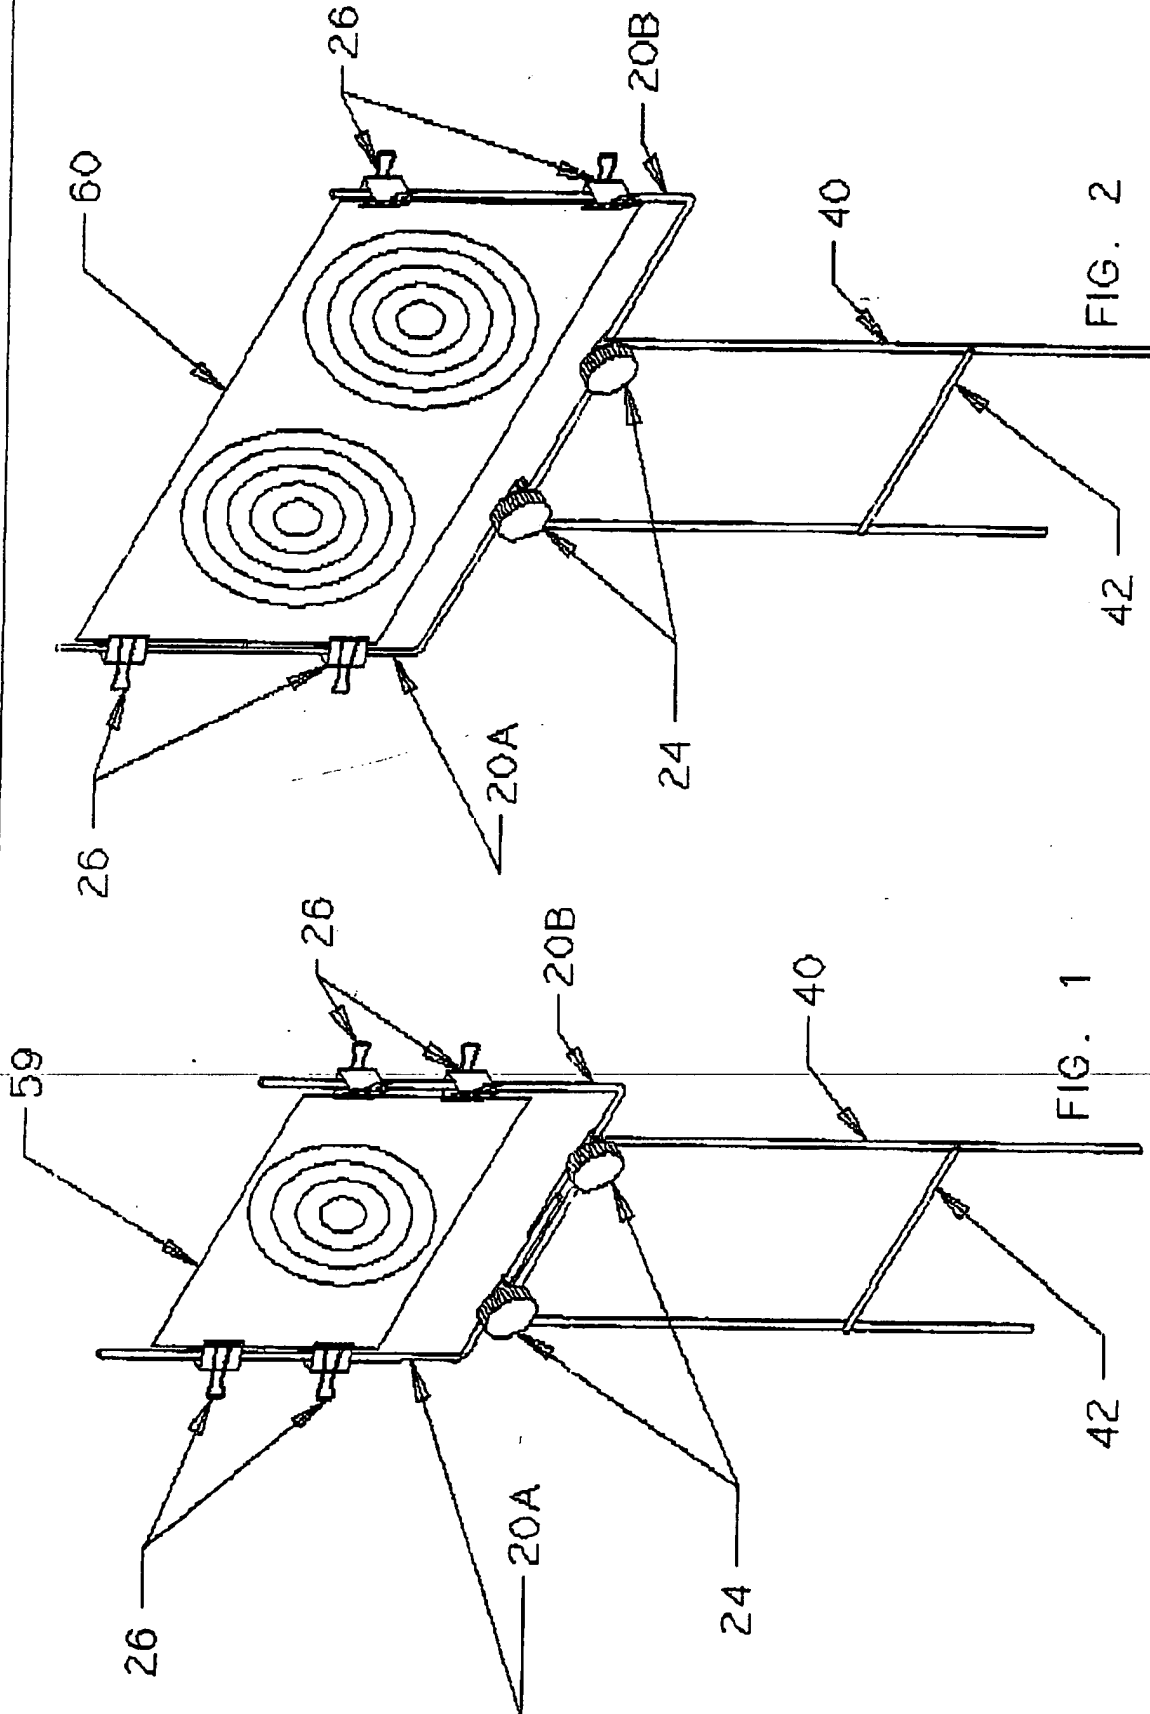


ADJUSTABLE SIGN/TARGET HOLDER

04/18/02

DWG. NO. ISOSIGN1


20 MAIN COMPONENT # 1
22 COLLAR
24 KNOB
26 CLIPS
40 MAIN COMPONENT # 2
42 BASE CROSS MEMBER

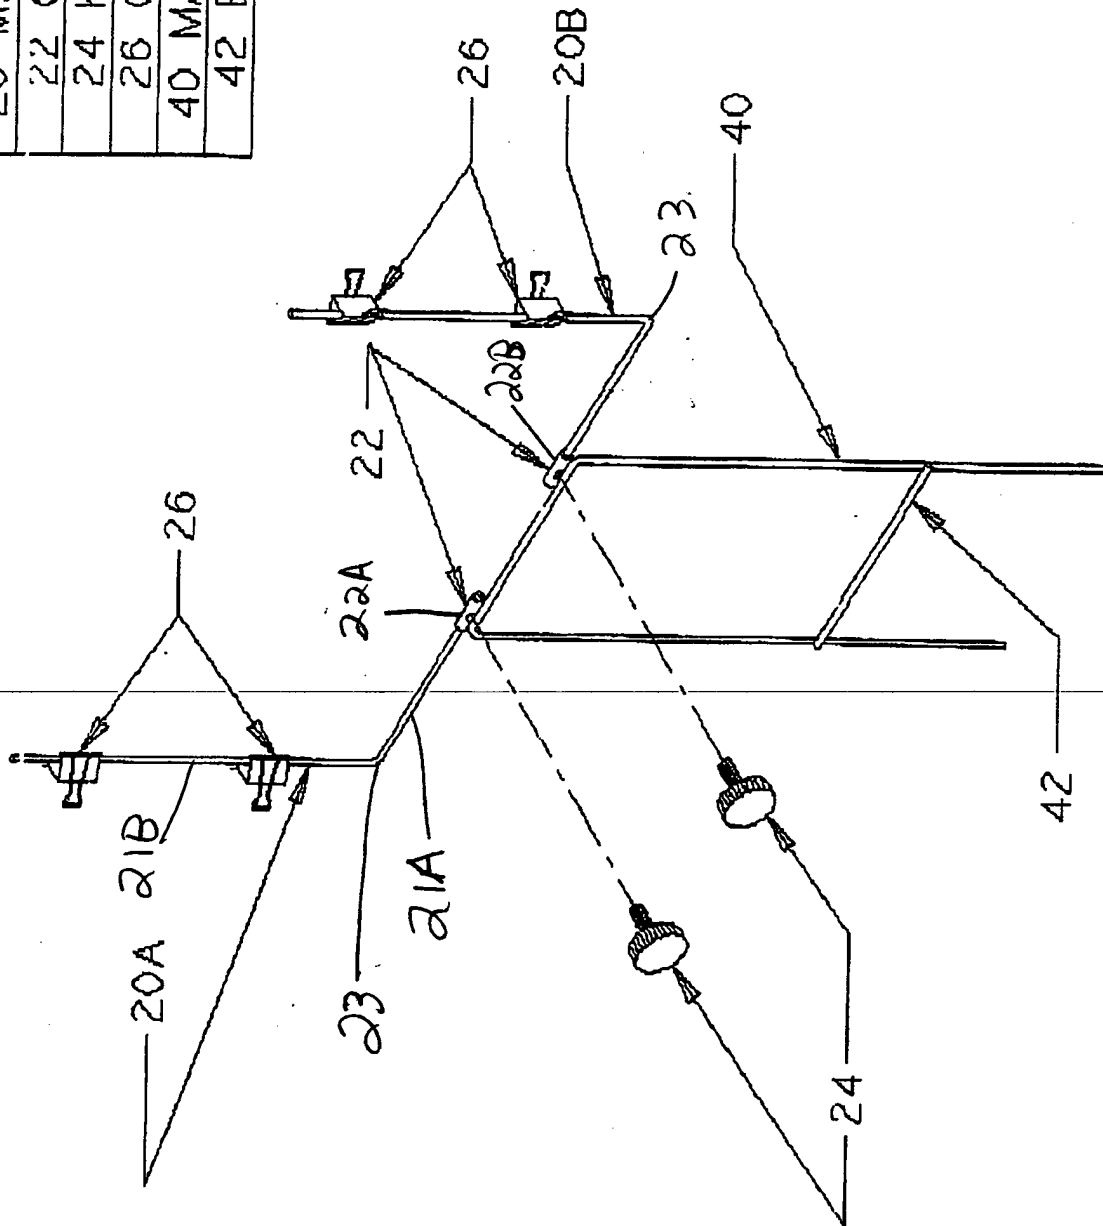

ADJUSTABLE SIGN/TARGET HOLDER FIGURE 3

DWG. NO. ISOSIGN2

04/18/02

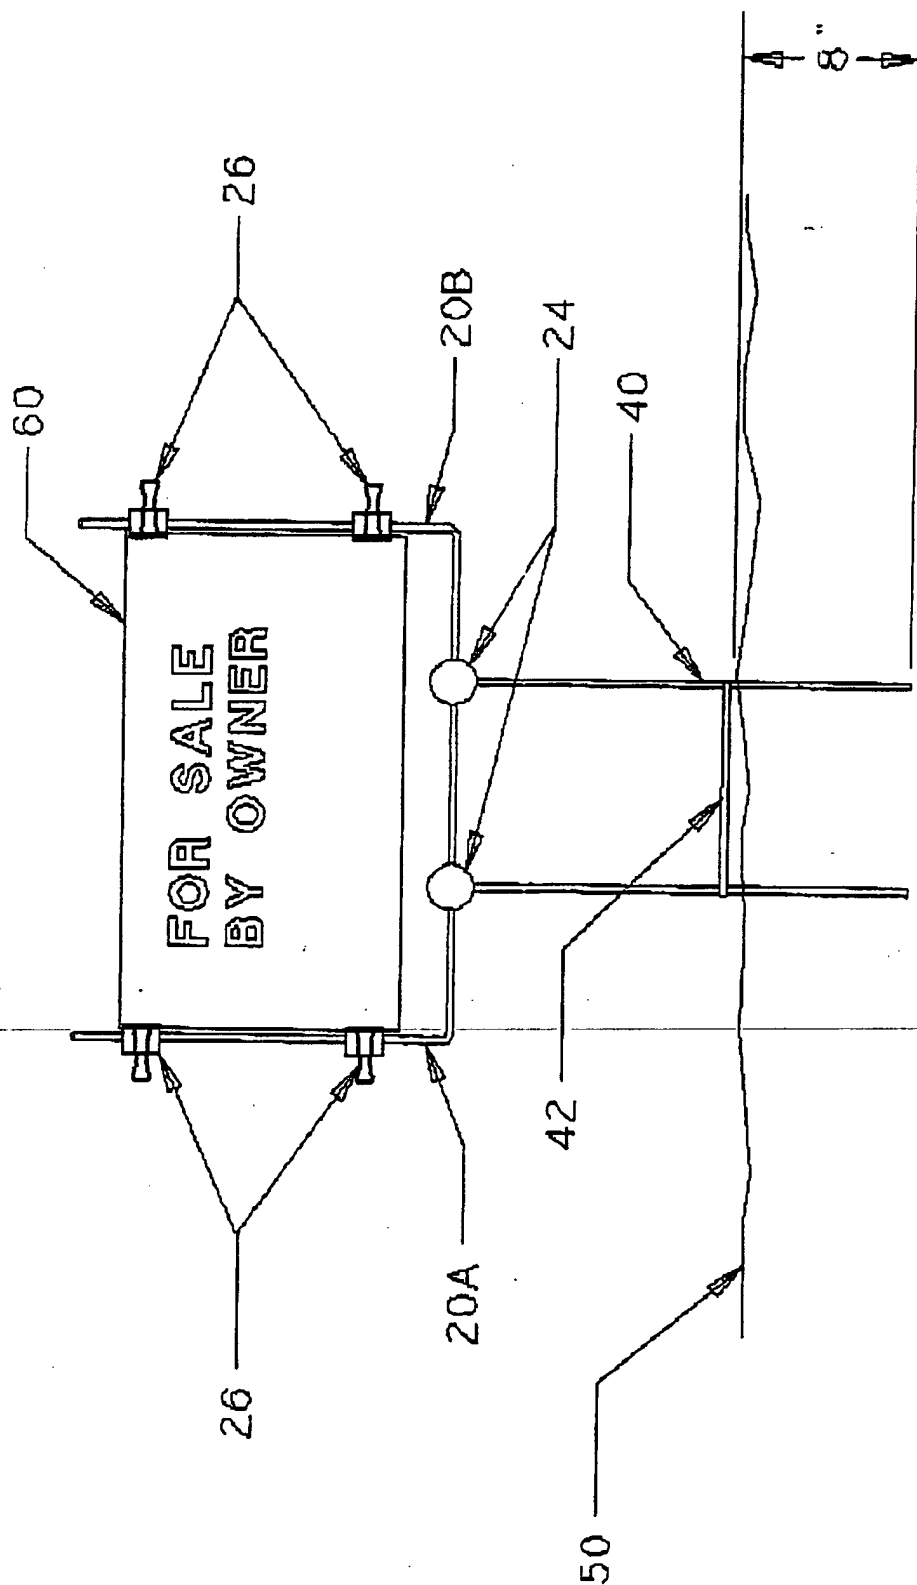

ADJUSTABLE SIGN/TARGET HOLDER FIGURE 4

04/18/02 DWG. NO. ISOSIGN3

20 MAIN COMPONENT # 1
22 COLLAR
24 KNOB
26 CLIPS
40 MAIN COMPONENT # 2
42 BASE CROSS MEMBER
50 HARD SURFACE BASE

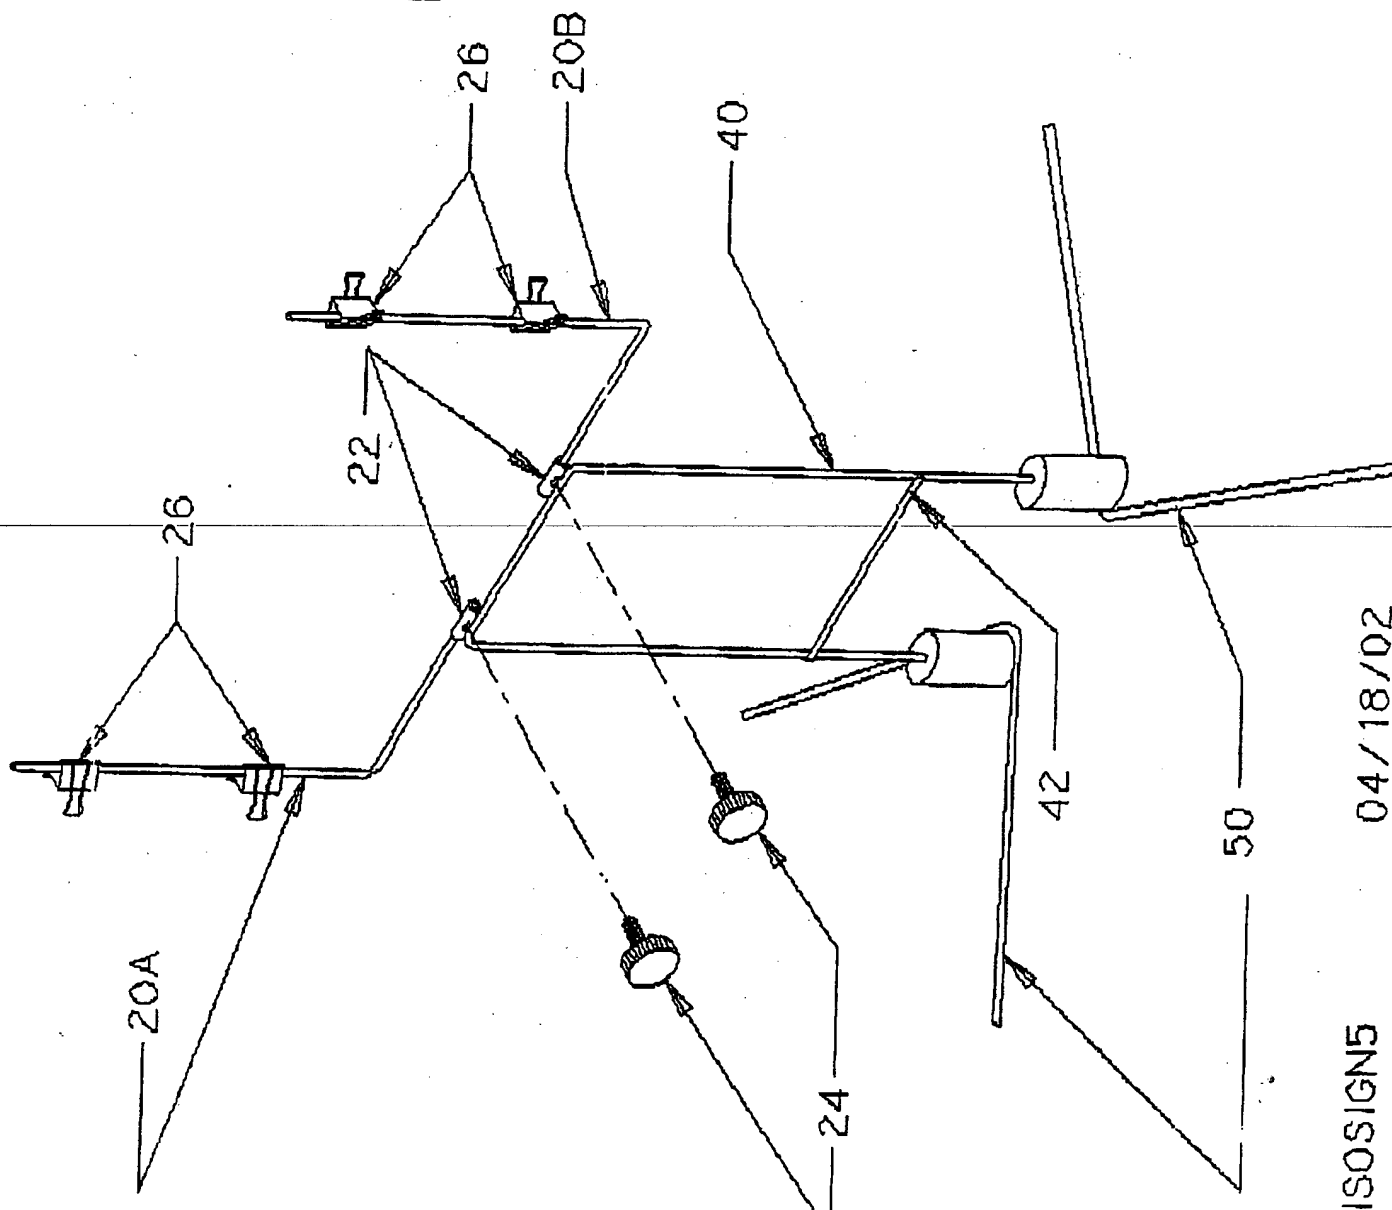


FIGURE 5

ISO SIGN5

04/18/02